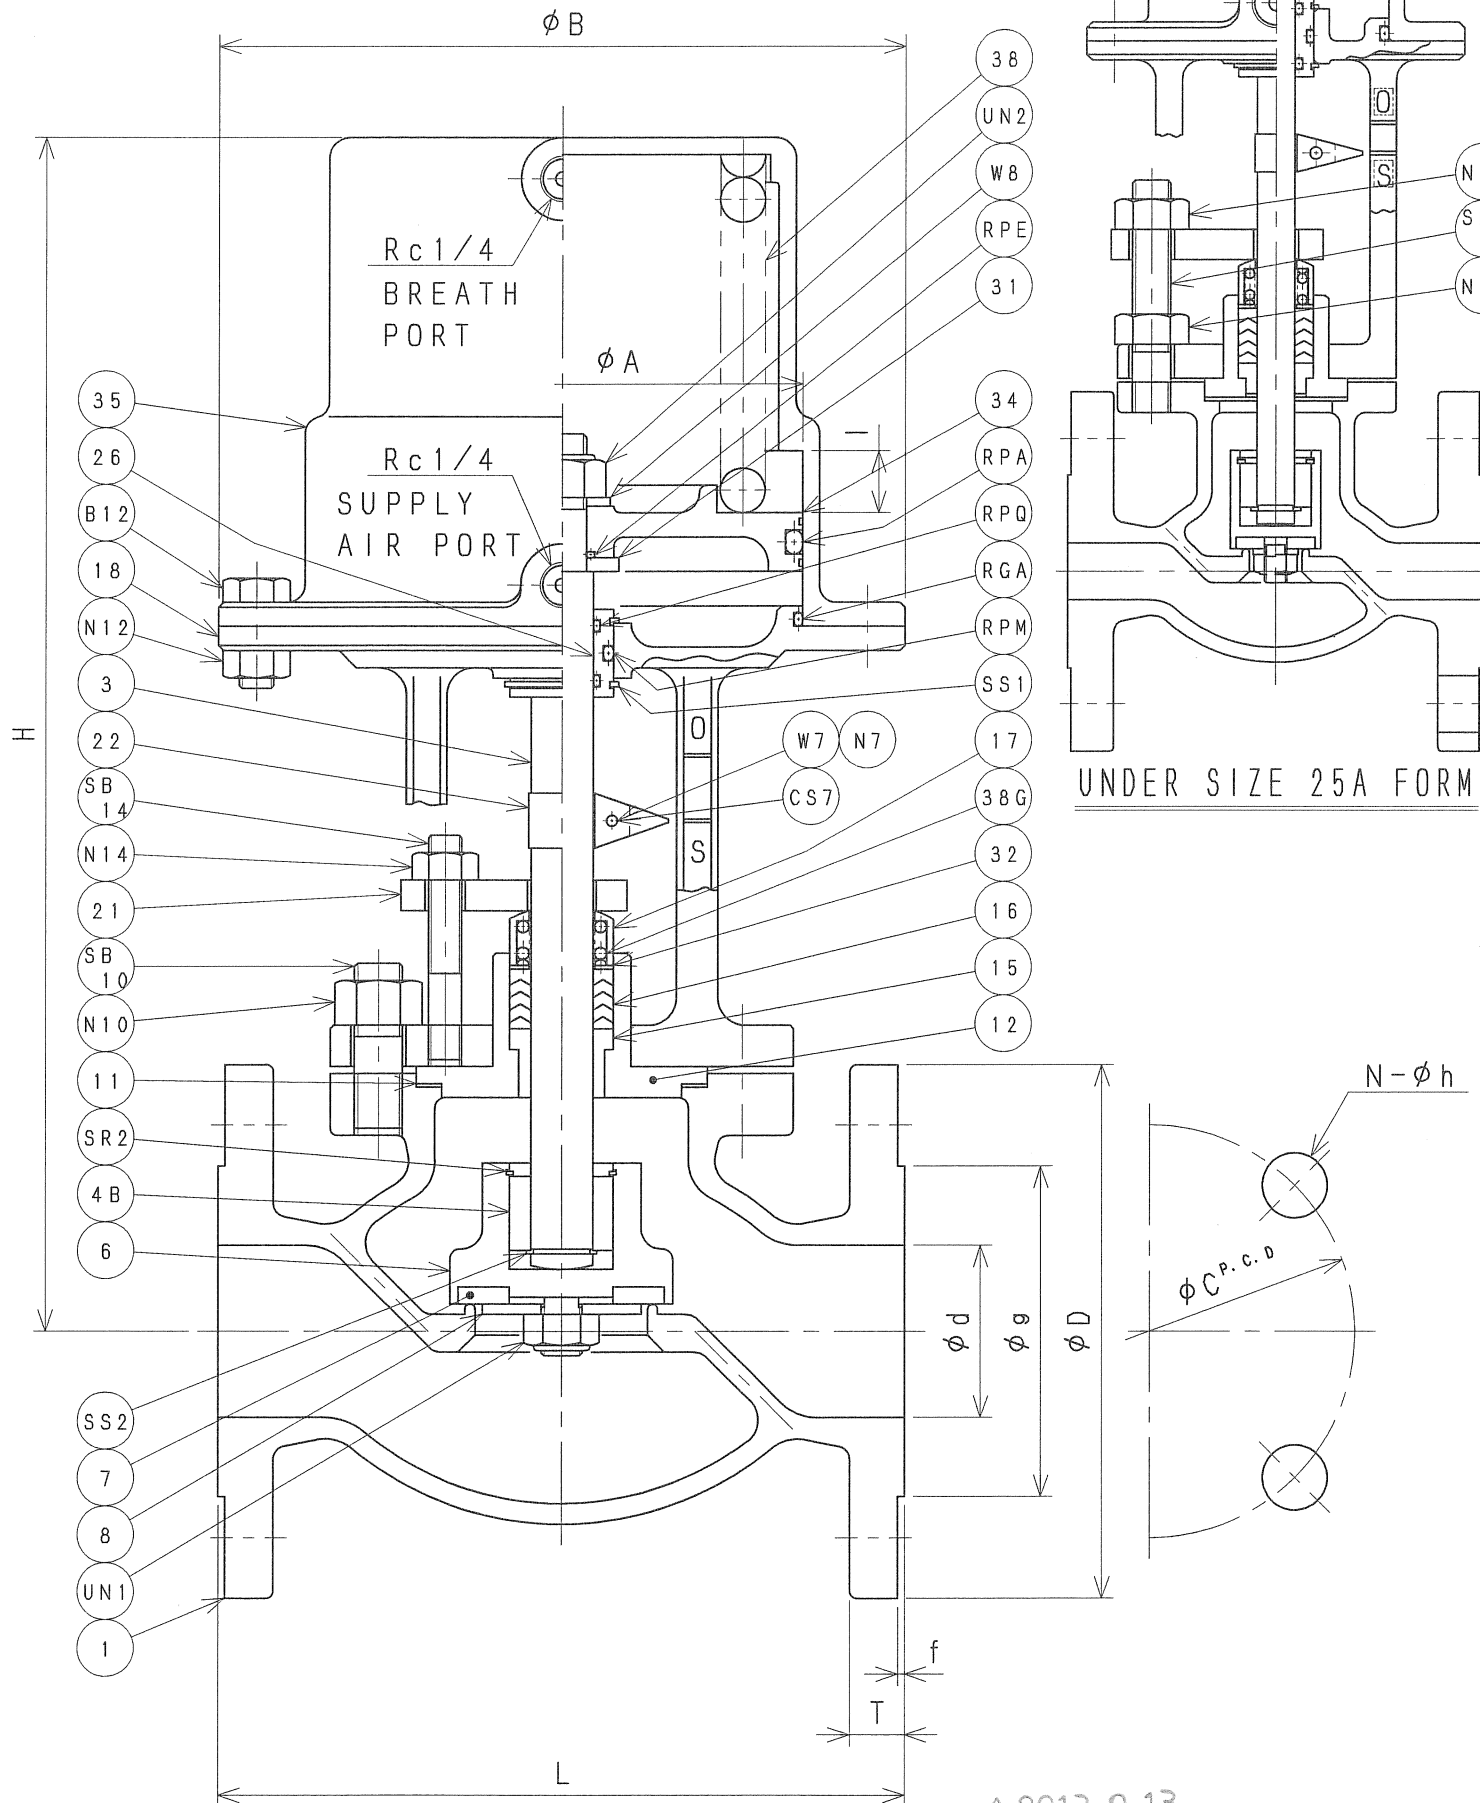

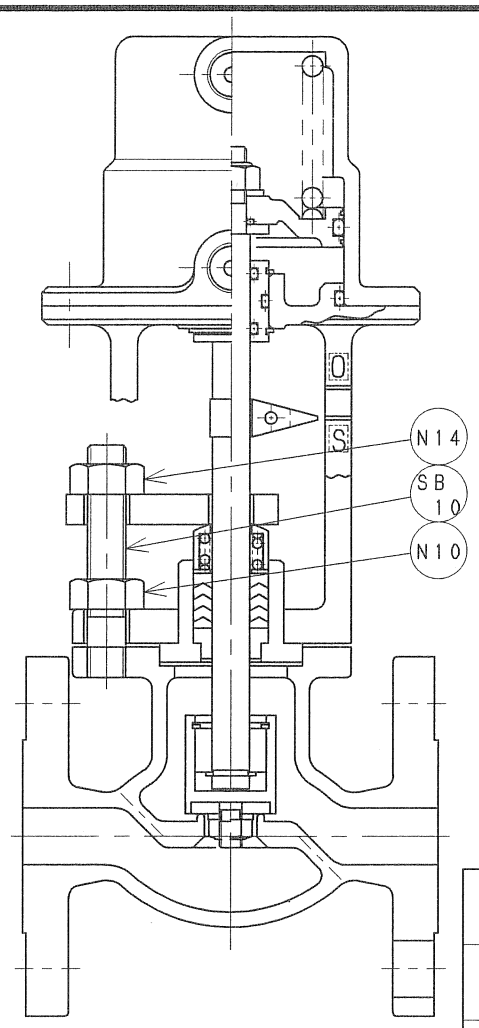

UNDER SIZE 25A FORM

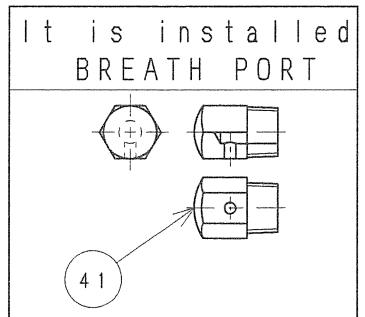

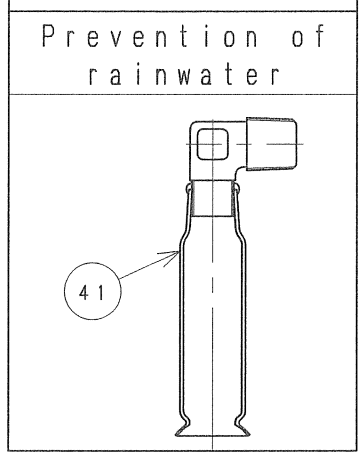

SIZE	d	L	H	I	A	B	D	C	g	T	f	N	h
15A	15	110	211	8	60	100	95	70	51	12	1	4	15
20A	20	120	249	12	90	135	100	75	56	14	1	4	15
25A	25	130	259	12	90	135	125	90	67	14	1	4	19
32A	40	190	309	15	110	170	135	100	76	16	2	4	19
40A	40	190	309	15	110	170	140	105	81	16	2	4	19
50A	50	200	347	18	140	200	155	120	96	16	2	4	19
65A	65	220	435	22	180	245	175	140	116	18	2	4	19
80A	80	240	462	26	200	265	185	150	126	18	2	8	19
100A	100	290	570	32	250	330	210	175	151	18	2	8	19

△△△△△△△△△

NO.	PART NAME	MATERIAL	Q.T.Y	REMARKS
W8	WASHER	SS400	1	
W7	WASHER	SUS304	1	
UN2	U-NUT	SS400	1	
UN1	U-NUT	SUS304	1	
SS2	SNAP RING	~~SUS316~~ ⚠	1	SUS 304
SS1	SNAP RING	SUS304	2	
SR2	SNAP RING	~~SUS316~~ ⚠	1	SUS 304
SB14	STUD BOLT	SS400	2	
SB10	STUD BOLT	SS400	2~8	
RPQ	O-RING	NBR	2	
RPM	O-RING	NBR	1	
RPE	O-RING	NBR	1	
RPA	O-RING	NBR	1	
RGA	O-RING	NBR	1	
N14	NUT	SS400	2	
N12	NUT	SS400	4~8	
N10	NUT	SS400	2~8	
N7	NUT	SUS304	1	
CS7	CROSS SCREW	SUS304	1	
B12	BOLT	SS400	4~8	
41	VENT NIPPLE	C3604B	1	
38G	SPRING	SUS304	1	
38	SPRING	SUP10	1	
35	CYLINDER	FCD450	1	
34	PISTON	FCD450	1	
32	GLAND WASHER	SUS304	1	
31	PISTON WASHER	SS400	1	
26	GUIDE	C3604B	1	
22	INDICATOR	SUS304	1	
21	GLAND FLANGE	SCS13	1	
18	YOKE	FCD450	1	
17	GLAND	SUS304	1	
16	GLAND PACKING	PTFE	1 SET	
15	GUIDE BUSH	PTFE	1	
12	BONNET	SUS304	1	
11	GASKET	PTFE	1	
8	DISC RETAINER	SUS304	1	
7	DISC	PTFE	1	GLASS FIBER
6	DISC HOLDER	SUS304	1	
4B	DISC HOLDER RING	SUS304	1	
3	STEM	SUS304	1	
1	BODY	SCS13	1	

WORKING		TEST PRESSURE		
PRESSURE	1.0M Pa		BODY	SEAT
TEMPERATURE	°C	HYDRAULIC	1.5M Pa	Pa
OPERATION PRESSURE	0.4M Pa	AIR	Pa	1.0M Pa

NOTE SCS13/SUS304/TEFLON/O-RING:NBR
JIS10K-RF FLANGE

NAME OF PRODUCT

N TYPE ON-OFF VALVE (R.A)

CHIEF OF DEPT		SCALE	
CHECKED BY	Y. Yamaguchi		
DESIGNED BY		DATE	JAN. 26. 2012
DRAWN BY	M. Takayanagi		

T.V VALVE CO., LTD. TOKYO JAPAN

DJ3A

DRAWING NO.	C00SV-570130-BE

⚠2013.9.13